


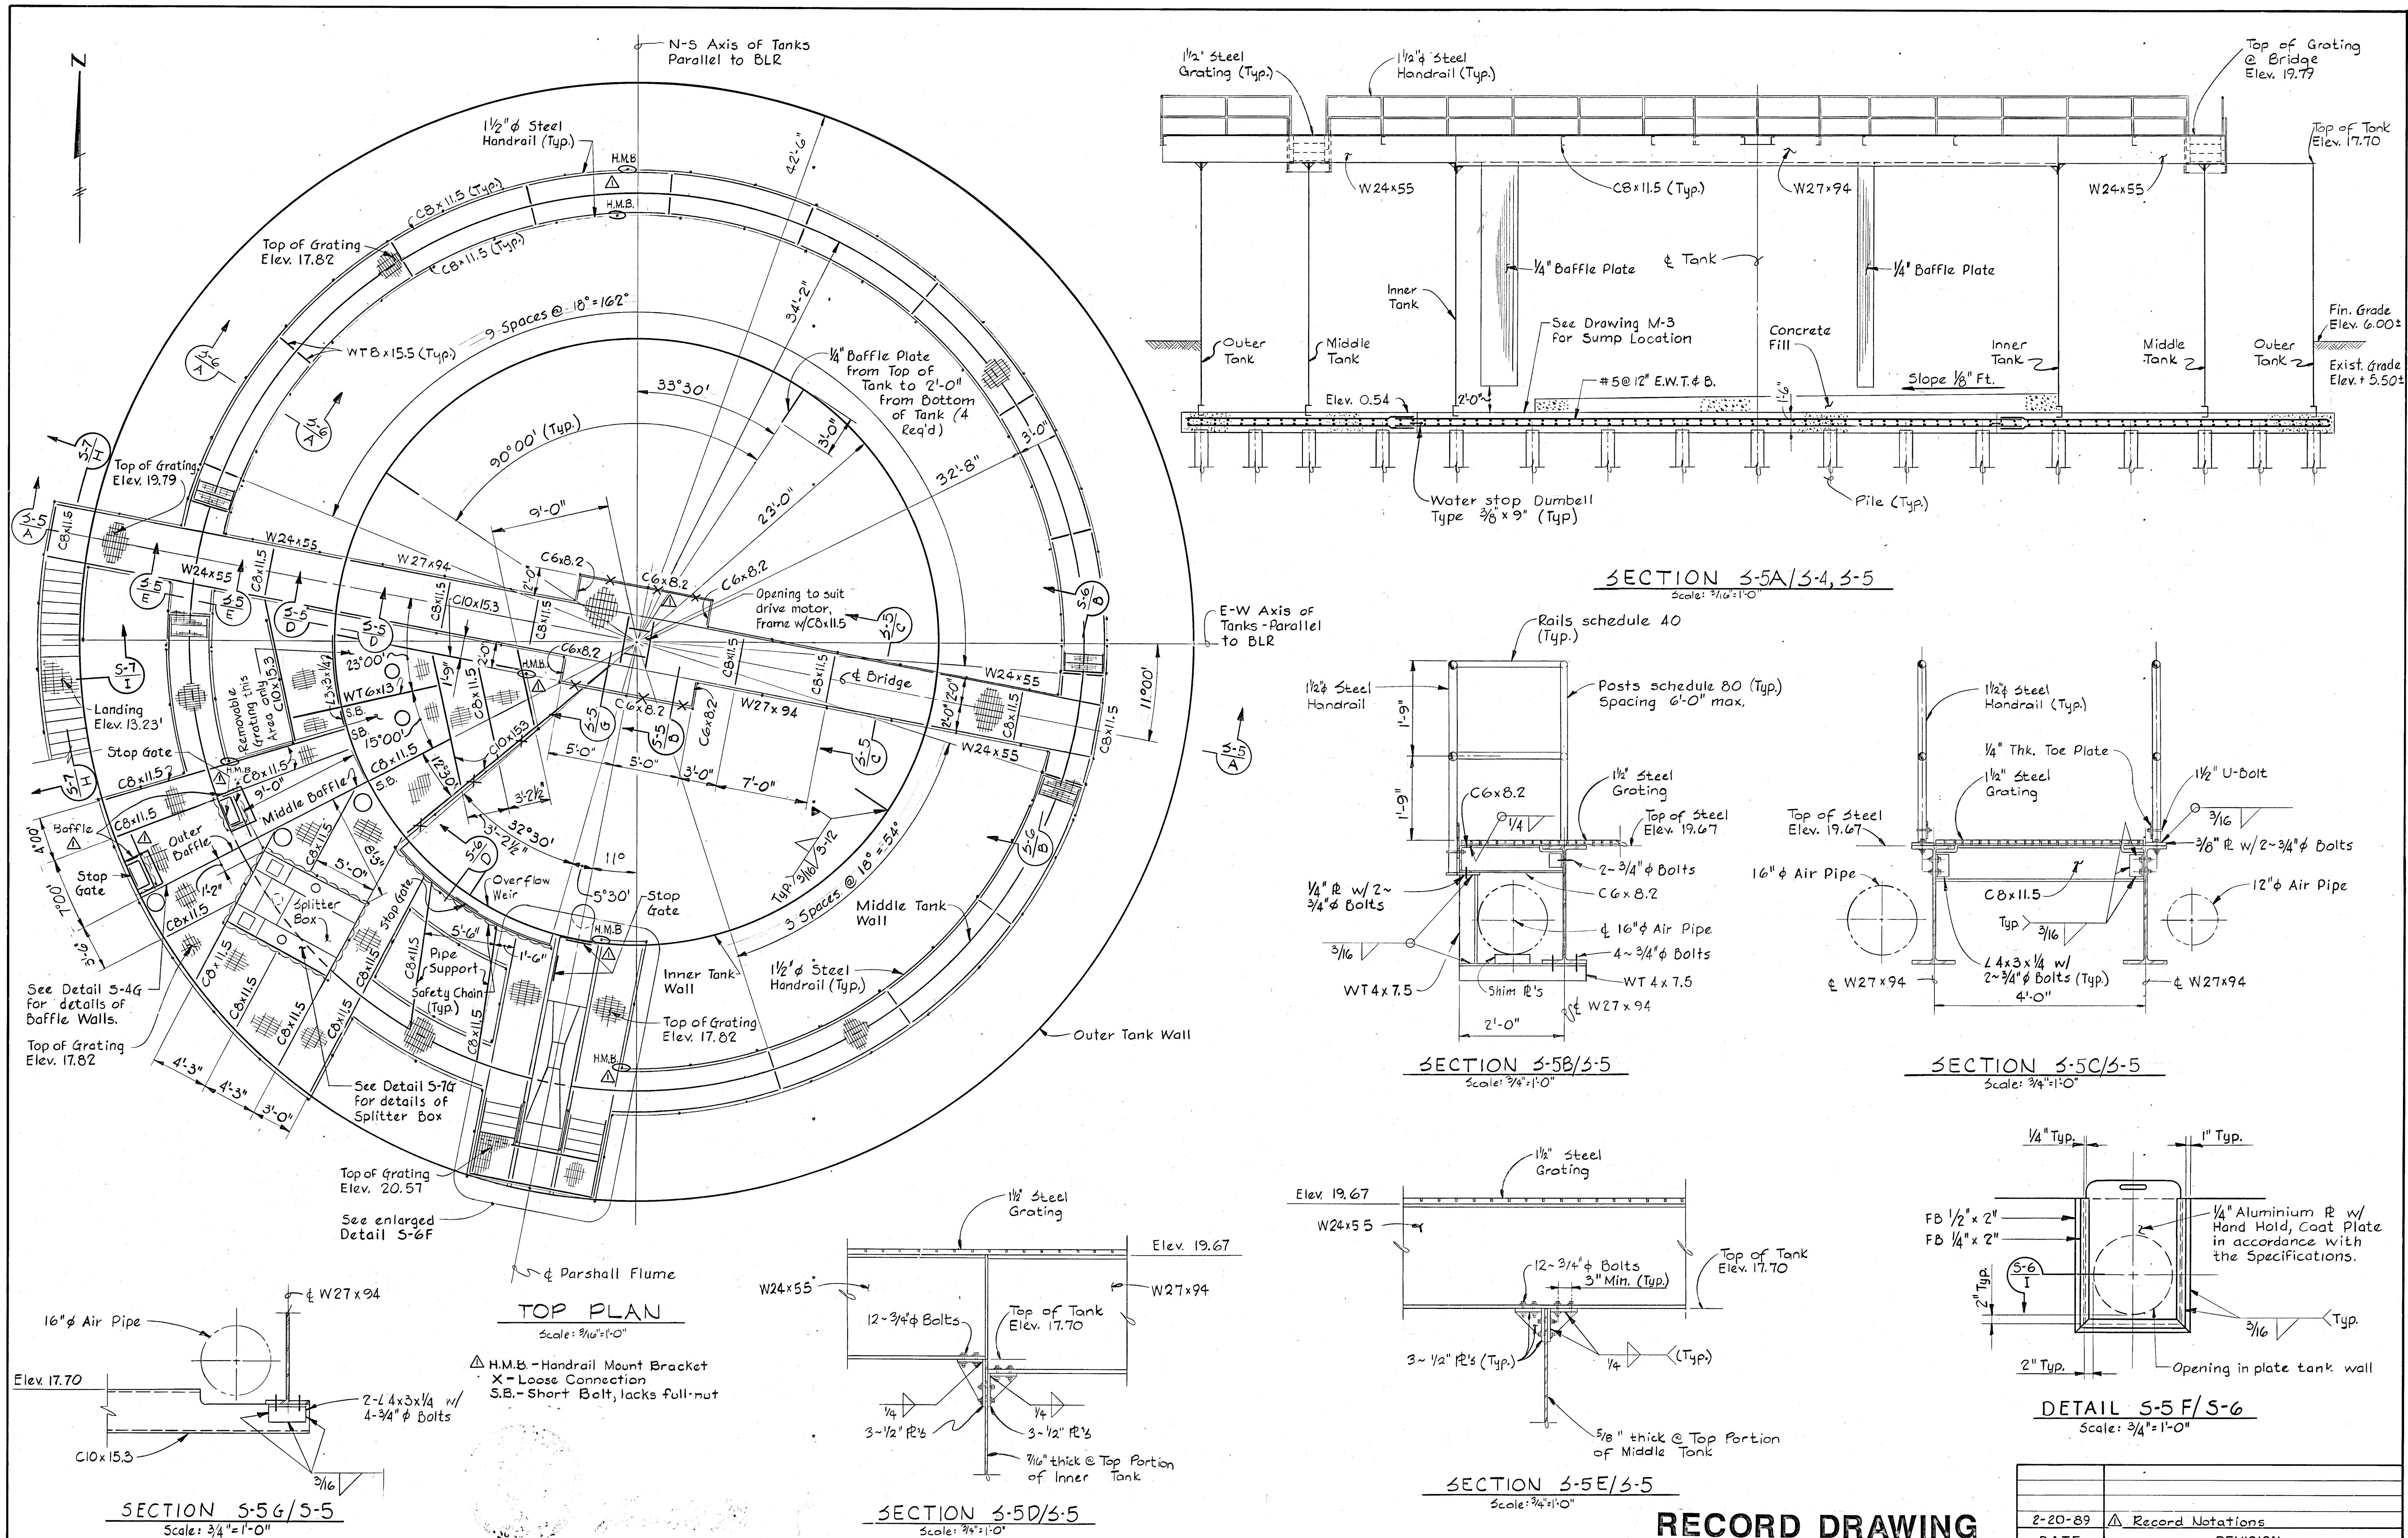

RECORD DRAWING

WHITMAN, REQUARDT AND ASSOCIATES
ENGINEERS
2315 SAINT PAUL STREET
BALTIMORE, MARYLAND 21218

MARYLAND MARINE UTILITIES, INC.
ROUTE 4, BOX 378
BERLIN, MARYLAND 21811

MARYLAND MARINE UTILITIES, INC.

WORCESTER COUNTY SANITARY COMMISSION

IMPROVEMENTS TO OCEAN PINES
WASTEWATER TREATMENT PLANT

FET-ASN
TREATMENT UNIT

SCALE
AS SHOWN
SHEET
S-5

DATE	REVISION
2-20-89	Record Notations