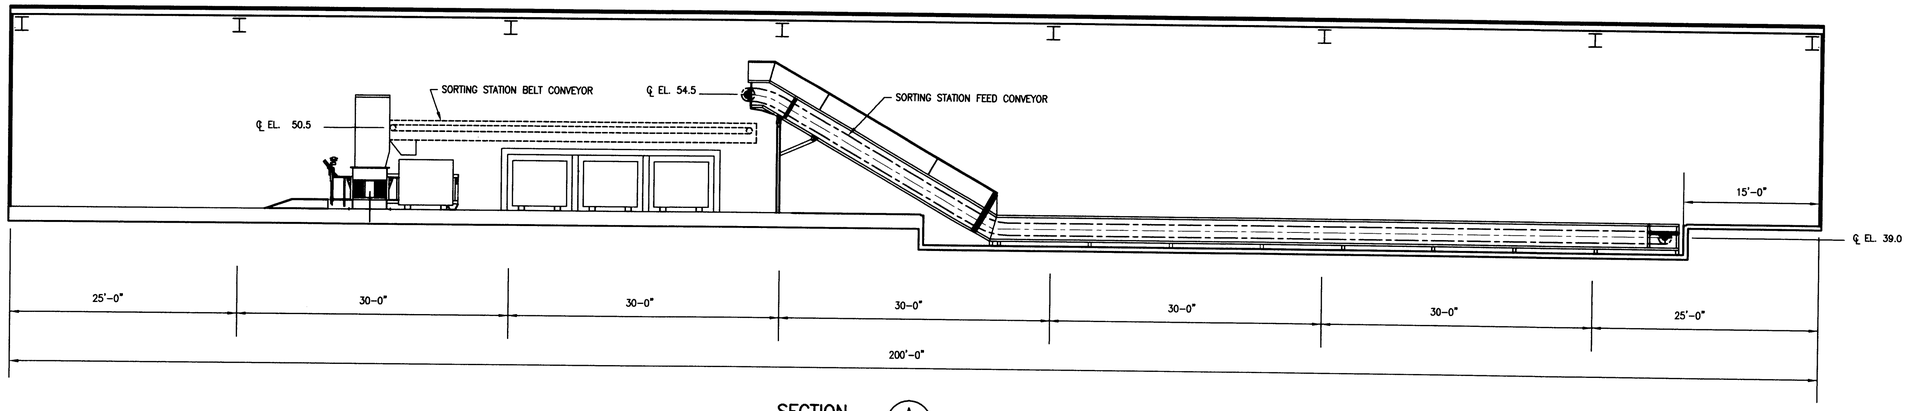

SECTION A/A-1
SCALE: 1/8" = 1'-0"

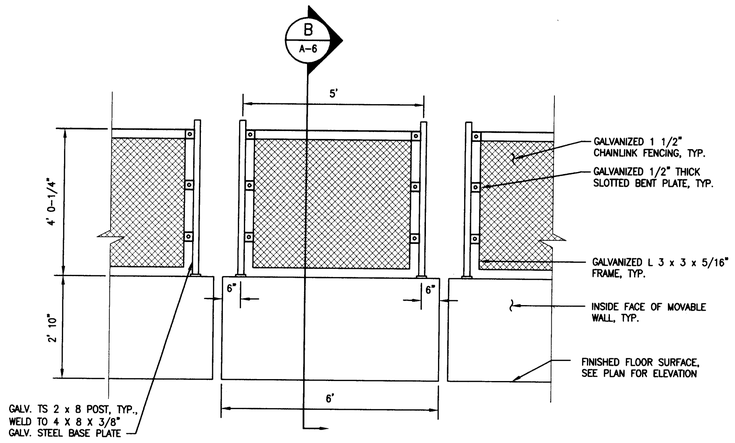

MOVABLE WALL DETAIL 2/A-1
SCALE: 1/2"=1'-0"

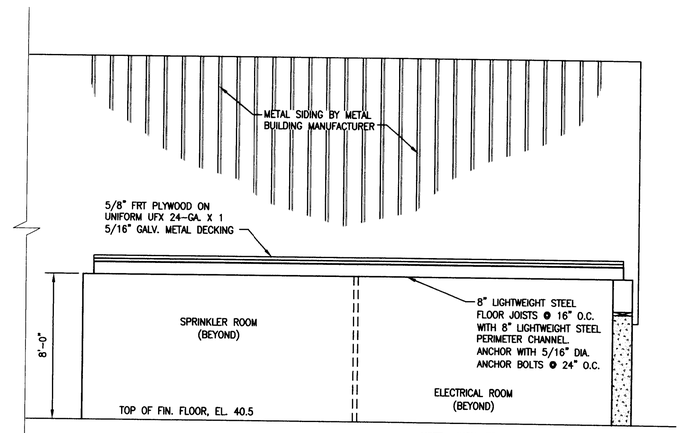

NOTE: INSULATE DECK WITH R-11, KRAFT-FACED BATT AND 5/8" GYPSUM BOARD CEILING.

INTERIOR ELEVATION 4/A-1
SCALE: ¼"=1'-0"

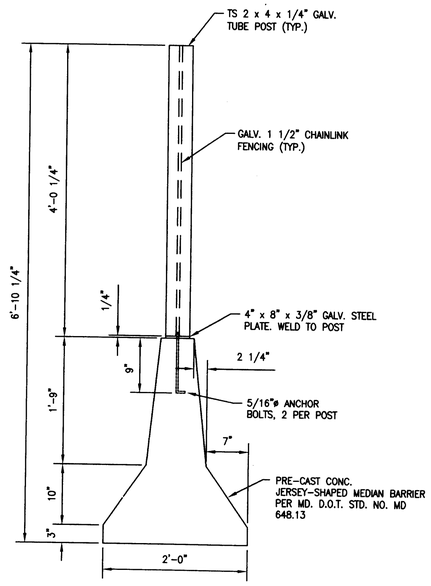

SECTION B/A-1
NOT TO SCALE
A-6

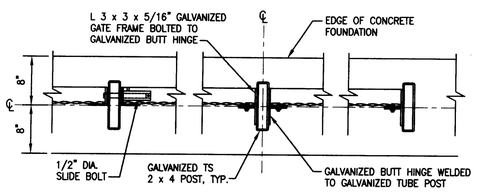

NOTE:
POSTS SHALL BE WELDED TO A 4" X 6" X 1/4" BASE PLATE. BASE PLATE SHALL BE WELDED TO CONVEYOR PIT EDGE ANGLE IRON.

GATE DETAIL 3/A-1
SCALE: 1/2"=1'-0"

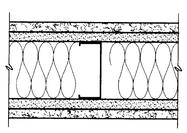

STEEL STUD – 5/8" TWO LAYERS ABUSE RESISTANT GYPSUM BOARD EACH SIDE, 3-5/8" STUDS 24" O.C., GYPSUM BOARD SCREW-ATTACHED, JOINTS STAGGERED AND TAPED, R-11 SOUND ATTENUATING BATT INSULATION

PARTITION DETAIL 1
NOT TO SCALE

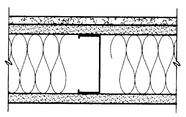

TWO LAYERS ABUSE RESISTANT, 5/8" FIRE-RATED GYPSUM BOARD ON 6" SW 20 LIGHTWEIGHT STEEL STUDS WITH 1 5/8" FLANGES @ 16" O.C., R-11 SOUND ATTENUATING BATT INSULATION; ONE LAYER 5/8" GYPSUM BOARD, SCREW ATTACHED AND TAPED

PARTITION DETAIL 2
NOT TO SCALE

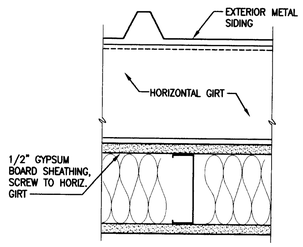

EXTERIOR METAL SIDING ON HORIZONTAL GIRTS (BY METAL BLDG. MFR.), ONE LAYER 1/2" SHEATHING SCREWED TO INSIDE FACE OF GIRTS; (4) 1/2", 20-GA. STEEL STUDS WITH TWO LAYERS ABUSE-RESISTANT GYPSUM BOARD INSIDE FACE, TAPED JOINTS, R-11 SOUND ATTENUATING BATT INSULATION

PARTITION DETAIL 3
NOT TO SCALE

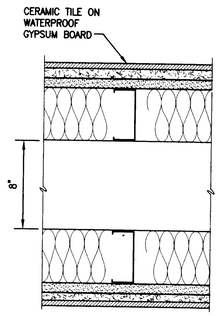

TWO LAYERS 5/8" WATERPROOF GYPSUM BOARD, ON EXPOSED FACES OF 3-1/2", 20-GA. STUDS WITH R-11 SOUND ATTENUATING BATT, CERAMIC TILE EACH SIDE

PARTITION DETAIL 4
NOT TO SCALE

8 4 0 4 8 12
SCALE: 1/8" = 1'-0"

REVISIONS

NO.	DATE	BY	DESCRIPTION

SEAL

STATE OF MARYLAND GEORGE KYLE JR. PROFESSIONAL ENGINEER

CENTRAL LANDFILL FACILITY SITE
MUNICIPAL SOLID WASTE RECOVERY FACILITY

WORCESTER COUNTY, MARYLAND

LONGITUDINAL CROSS SECTION AND DETAILS

EA ENGINEERING, SCIENCE, AND TECHNOLOGY
Loveton Center
15 Loveton Circle
Sparks, Maryland 21152
(410) 771-4950

DATE	MAY 2002
DESIGNED BY	DOK
DRAWN BY	FDV
CHECKED BY	GAT
PROJECT MANAGER	GCG
PROJECT NUMBER	10609.14
SCALE	AS SHOWN
FILE NAME	A-6
DRAWING NUMBER	A-6
SHEET NUMBER	13 OF 31

FILE: (LOVETON) Q:\PROJECTS\10609\4\CONTRACT DRAWINGS\A-6.DWG 6-3-02