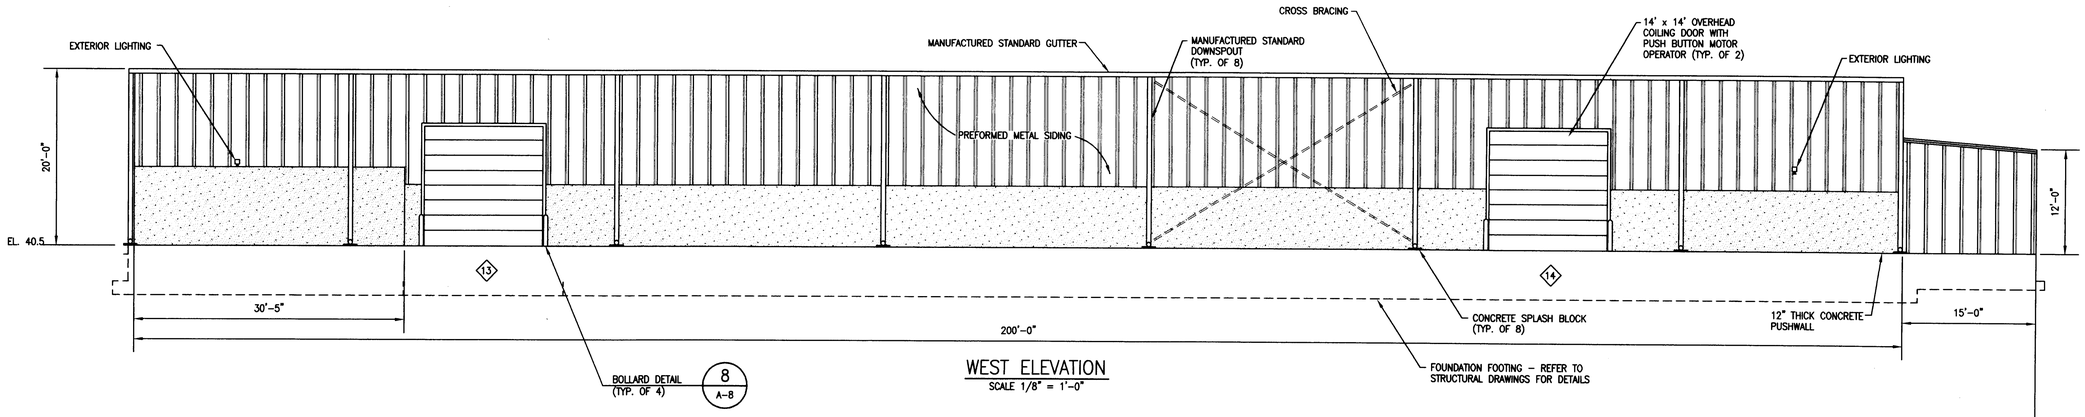

WEST ELEVATION
SCALE 1/8" = 1'-0"

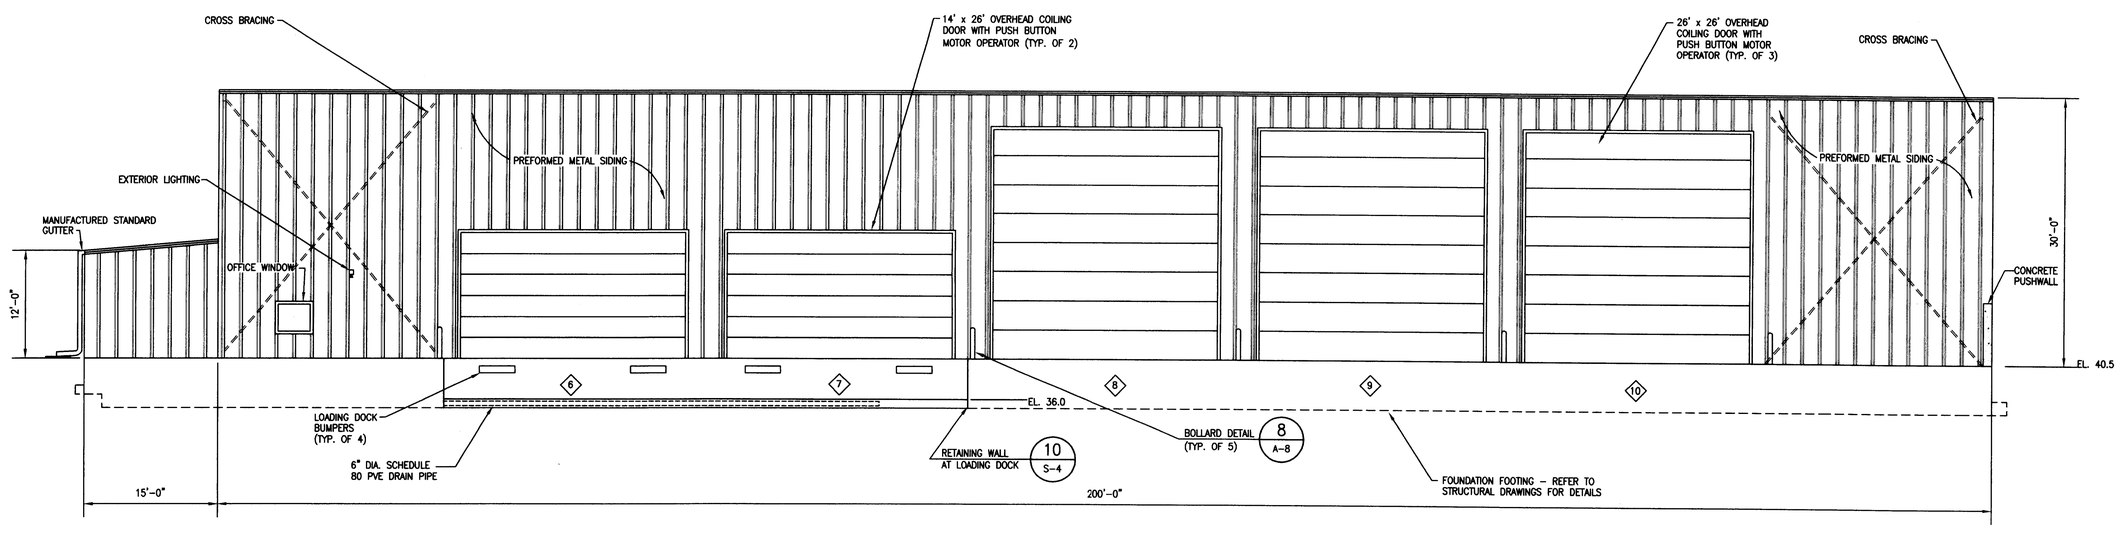

EAST ELEVATION
SCALE 1/8" = 1'-0"

8 4 0 4 8 12
SCALE: 1/8" = 1'-0"

REVISIONS

NO.	DATE	BY	DESCRIPTION

SEAL

STATE OF MARYLAND GEOFFREY A. TAYLOR REGISTERED PROFESSIONAL ENGINEER No. 19811

CENTRAL LANDFILL FACILITY SITE
MUNICIPAL SOLID WASTE RECOVERY FACILITY
WORCESTER COUNTY, MARYLAND

EAST & WEST ELEVATIONS

EA ENGINEERING, SCIENCE, AND TECHNOLOGY
Loveton Center
15 Loveton Circle
Sparks, Maryland 21152
(410) 771-4950

DATE	MAY 2002
DESIGNED BY	DOK
DRAWN BY	FDV
CHECKED BY	GAT
PROJECT MANAGER	GCG
PROJECT NUMBER	10609.14
SCALE	AS SHOWN
FILE NAME	A-2
DRAWING NUMBER	A-2
SHEET NUMBER	9 OF 31

FILE: (LOVETON) Q:\PROJECTS\10609.14\CONTRACTDRAWINGS\A-2.DWG 6-3-02