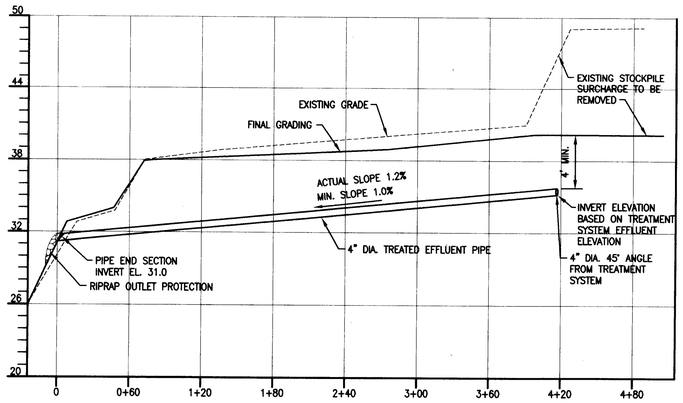

PROFILE 1 / C-2
SCALE: HORIZ.: 1" = 60'
VERT.: 1" = 6'

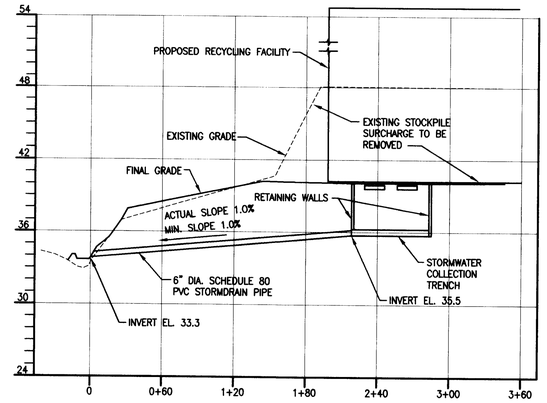

PROFILE 2 / C-2
SCALE: HORIZ.: 1" = 60'
VERT.: 1" = 6'

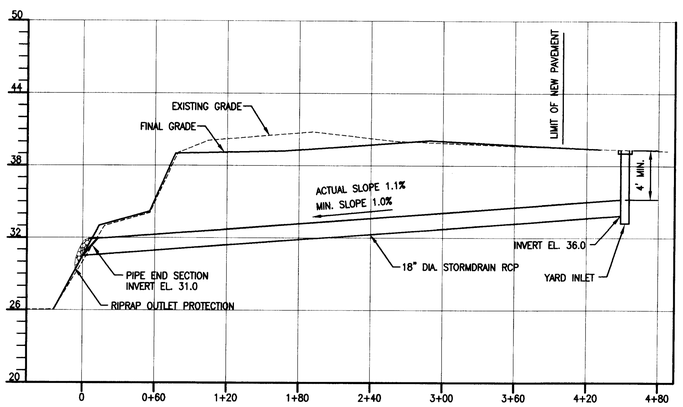

PROFILE 3 / C-2
SCALE: HORIZ.: 1" = 60'
VERT.: 1" = 6'

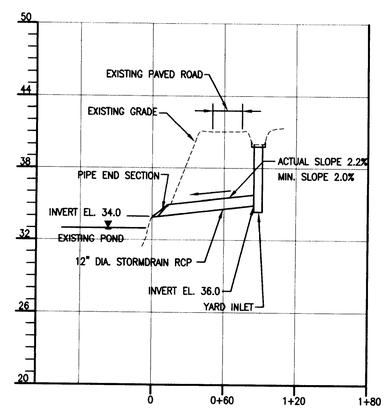

PROFILE 4 / C-2
SCALE: HORIZ.: 1" = 60'
VERT.: 1" = 6'

60 30 0 60 120
GRAPHIC SCALE IN FEET

NO.	DATE	BY	REVISIONS DESCRIPTION

SEAL

STATE OF MARYLAND GEORGE A. TOWNSEND III REGISTERED PROFESSIONAL ENGINEER

CENTRAL LANDFILL FACILITY SITE
MUNICIPAL SOLID WASTE RECOVERY FACILITY

WORCESTER COUNTY, MARYLAND

PIPE PROFILES

EA ENGINEERING, SCIENCE, AND TECHNOLOGY
Loveton Center
15 Loveton Circle
Sparks, Maryland 21152
(410) 771-4950

DATE	MAY 2002
DESIGNED BY	DOK
DRAWN BY	FDV
CHECKED BY	GAT
PROJECT MANAGER	GAT
PROJECT NUMBER	10609.14
SCALE	AS SHOWN
FILE NAME	C-6
DRAWING NUMBER	C-6
SHEET NUMBER	7 OF 31

FILE: [LOVETON] Q:\PROJECTS\10609\CONTRACT DRAWINGS\C-6.DWG 6-3-02