DOOR AND FRAME SCHEDULE

MARK	DOOR NOMINAL SIZE	DOOR TYPE	DOOR MATERIAL	FRAME TYPE	FRAME DETAIL	THROAT DIM.	THRESHOLD	LABEL	HARDWARE	REMARKS
1	3'-0" x 7'-0"	3	HLW MTL	B	1				1	
2	3'-0" x 7'-0"	3	HLW MTL	B	1				1	
3	5'-0" x 7'-0"	5	HLW MTL	A	1				1	
4	3'-0" x 7'-0"	3	HLW MTL	B	1				1	
5	3'-0" x 7'-0"	3	HLW MTL	B	1				1	
6	26 FT x 14 FT	1	ALUMINUM	NA	1				NA	
7	26 FT x 14 FT	1	ALUMINUM	NA	1				NA	
8	26 FT x 26 FT	1	ALUMINUM	NA	1				NA	
9	26 FT x 26 FT	1	ALUMINUM	NA	1				NA	
10	26 FT x 26 FT	1	ALUMINUM	NA	1				NA	
11	3'-0" x 7'-0"	3	HLW MTL	B	1				1	
12	3'-0" x 7'-0"	3	HLW MTL	B	1				1	
13	14 FT x 14 FT	2	ALUMINUM	NA	1				NA	
14	14 FT x 14 FT	2	ALUMINUM	NA	1				NA	
15	3'-0" x 7'-0"	4	HLW MTL	B	2				2,A	
16	3'-0" x 7'-0"	4	HLW MTL	B	2				3	
17	3'-0" x 7'-0"	4	HLW MTL	B	2				2,B	
18	3'-0" x 7'-0"	3	HLW MTL	B	1				1	
19	3'-0" x 7'-0"	3	HLW MTL	B	2				2,B	
20	3'-0" x 6'-8"	3	HLW WD	A	2				–	

FRAME DETAIL NOTES: 1. BY METAL BUILDING MANUFACTURER.
2. BY GENERAL CONTRACTOR. SEE DOOR FRAME DETAIL 7 SHEET A-7.

FINISH SCHEDULE

ROOM NO.	ROOM NAME	FLOOR MATERIAL	FLOOR COLOR	BASE MATERIAL	BASE COLOR	WAINSCOT MATERIAL	WAINSCOT COLOR	WALL MATERIAL	WALL COLOR	CEILING MATERIAL	CEILING COLOR	NOTES
001	TIPPING/SORTING	CONCRETE		VINYL		GYP. BOARD		GYP. BOARD		NONE		
002	ELECTRICAL ROOM	CONCRETE		VINYL		GYP. BOARD		GYP. BOARD		GYP. BOARD		
003	MECH. EQUIP.	CONCRETE		VINYL		GYP. BOARD		GYP. BOARD		NONE		
004	WOMEN	CERAMIC TILE		CERAMIC		CERAMIC		W.P. C.B		LAY-IN		WALL MATERIAL IS WATER
005	KITCHEN	CONCRETE		VINYL		GYP. BOARD		W.P. C.B		LAY-IN		PROOF GYPSUM BOARD
006	MEN	CERAMIC TILE		CERAMIC		CERAMIC		W.P. C.B		LAY-IN		" " "
007	OFFICE	CONCRETE		VINYL		GYP. BOARD		GYP. BOARD		LAY-IN		
008	BREAK ROOM	CONCRETE		VINYL		GYP. BOARD		GYP. BOARD		LAY-IN		
009	SHOP	CONCRETE		VINYL		GYP. BOARD		GYP. BOARD		NONE		
010	CLOSET	CONCRETE		VINYL		GYP. BOARD		GYP. BOARD		LAY-IN		

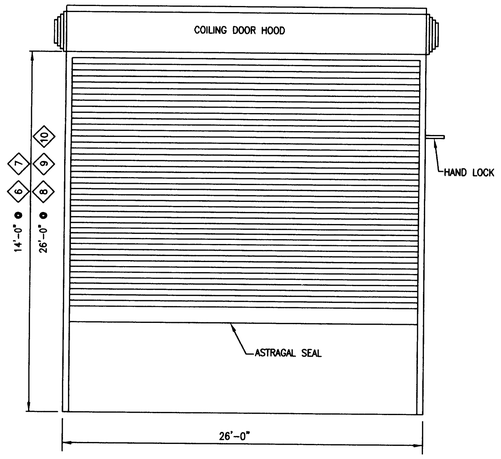

DOOR TYPE 1

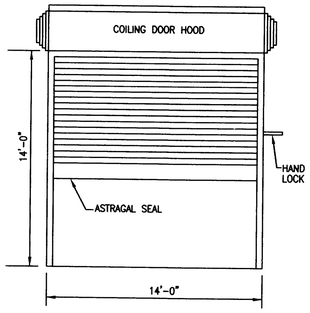

DOOR TYPE 2

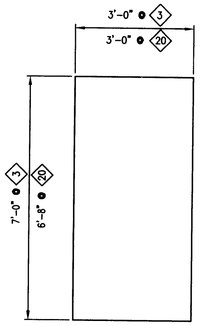

DOOR TYPE 3

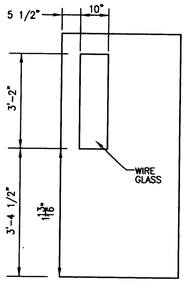

DOOR TYPE 4

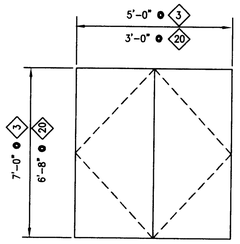

DOOR TYPE 5

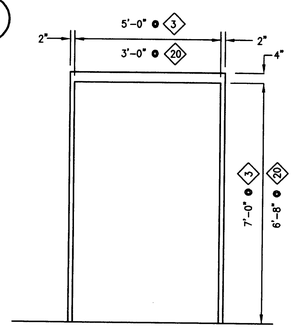

FRAME TYPE A

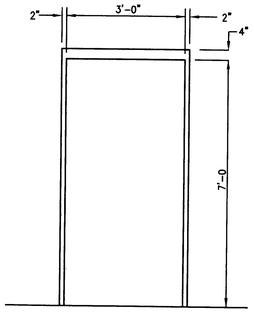

FRAME TYPE B

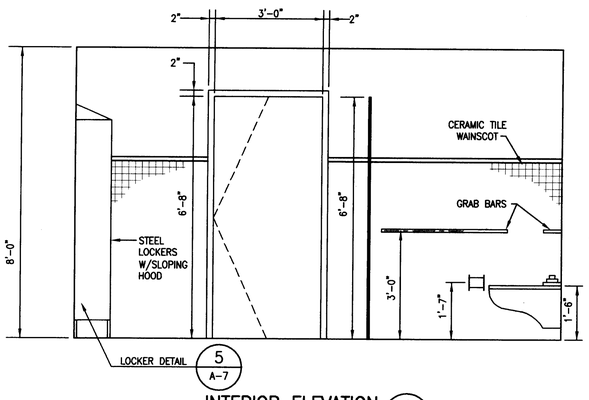

INTERIOR ELEVATION 1 A-5

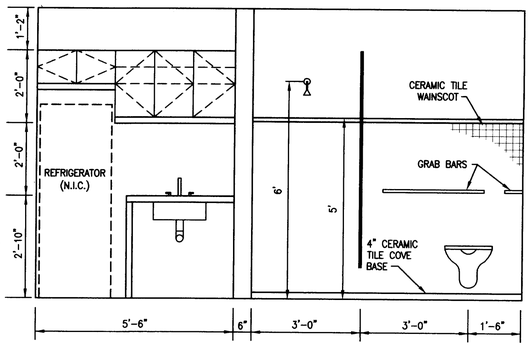

INTERIOR ELEVATION 2 A-5

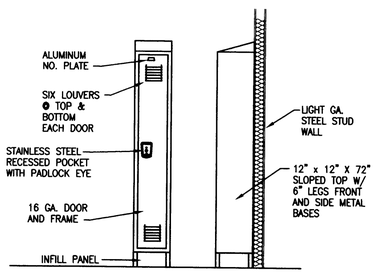

LOCKER DETAIL 5 A-7
NOT TO SCALE

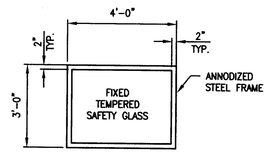

WINDOW TYPE 6-A

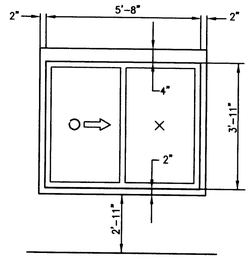

WINDOW TYPE 6-B

WINDOW TYPE DETAIL 6 A-5

NOTE: WINDOW TYPE 6-A BY METAL BUILDING MFR.

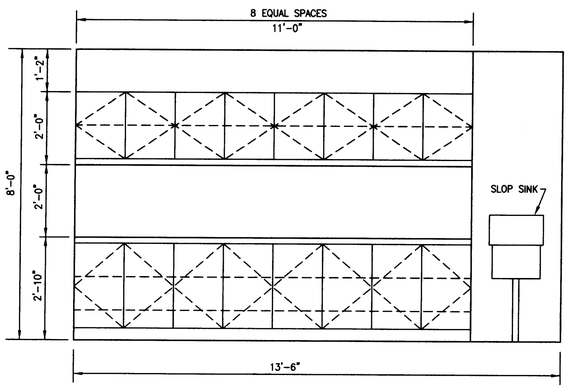

INTERIOR ELEVATION 3 A-5

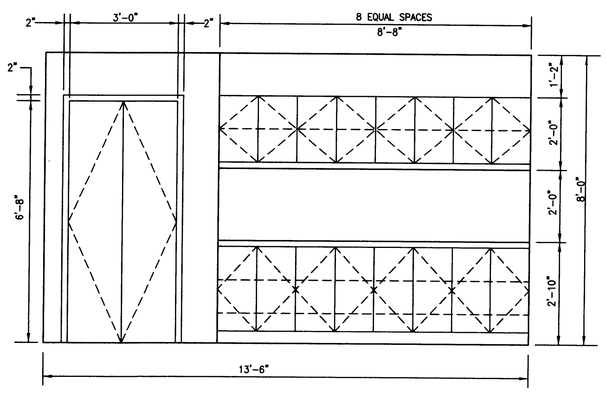

INTERIOR ELEVATION 4 A-5

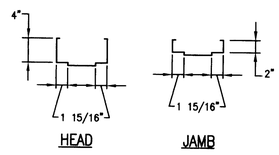

DOOR FRAME DETAILS 7 A-7
SCALE: 1 1/2" = 1'-0"

2 1 0 1 2 3
SCALE: 1/2" = 1'-0"

NO.	DATE	BY	DESCRIPTION

REVISIONS

SEAL

STATE OF MARYLAND GEORGE A. TOMAS III REGISTERED PROFESSIONAL ENGINEER

CENTRAL LANDFILL FACILITY SITE
MUNICIPAL SOLID WASTE RECOVERY FACILITY
WORCESTER COUNTY, MARYLAND

FINISH AND DOOR SCHEDULES AND DETAILS

EA ENGINEERING, SCIENCE, AND TECHNOLOGY
Loveton Center
15 Loveton Circle
Sparks, Maryland 21152
(410) 771-4950

DATE	MAY 2002
DESIGNED BY	DOK
DRAWN BY	FDV
CHECKED BY	GAT
PROJECT MANAGER	GAT
PROJECT NUMBER	10609.14
SCALE	AS SHOWN
FILE NAME	A-7
DRAWING NUMBER	A-7
SHEET NUMBER	14 OF 31

FILE: (LOVETON) Q:\PROJECTS\10609\14\CONTRACT DRAWINGS\A-7.DWG 6-3-02